




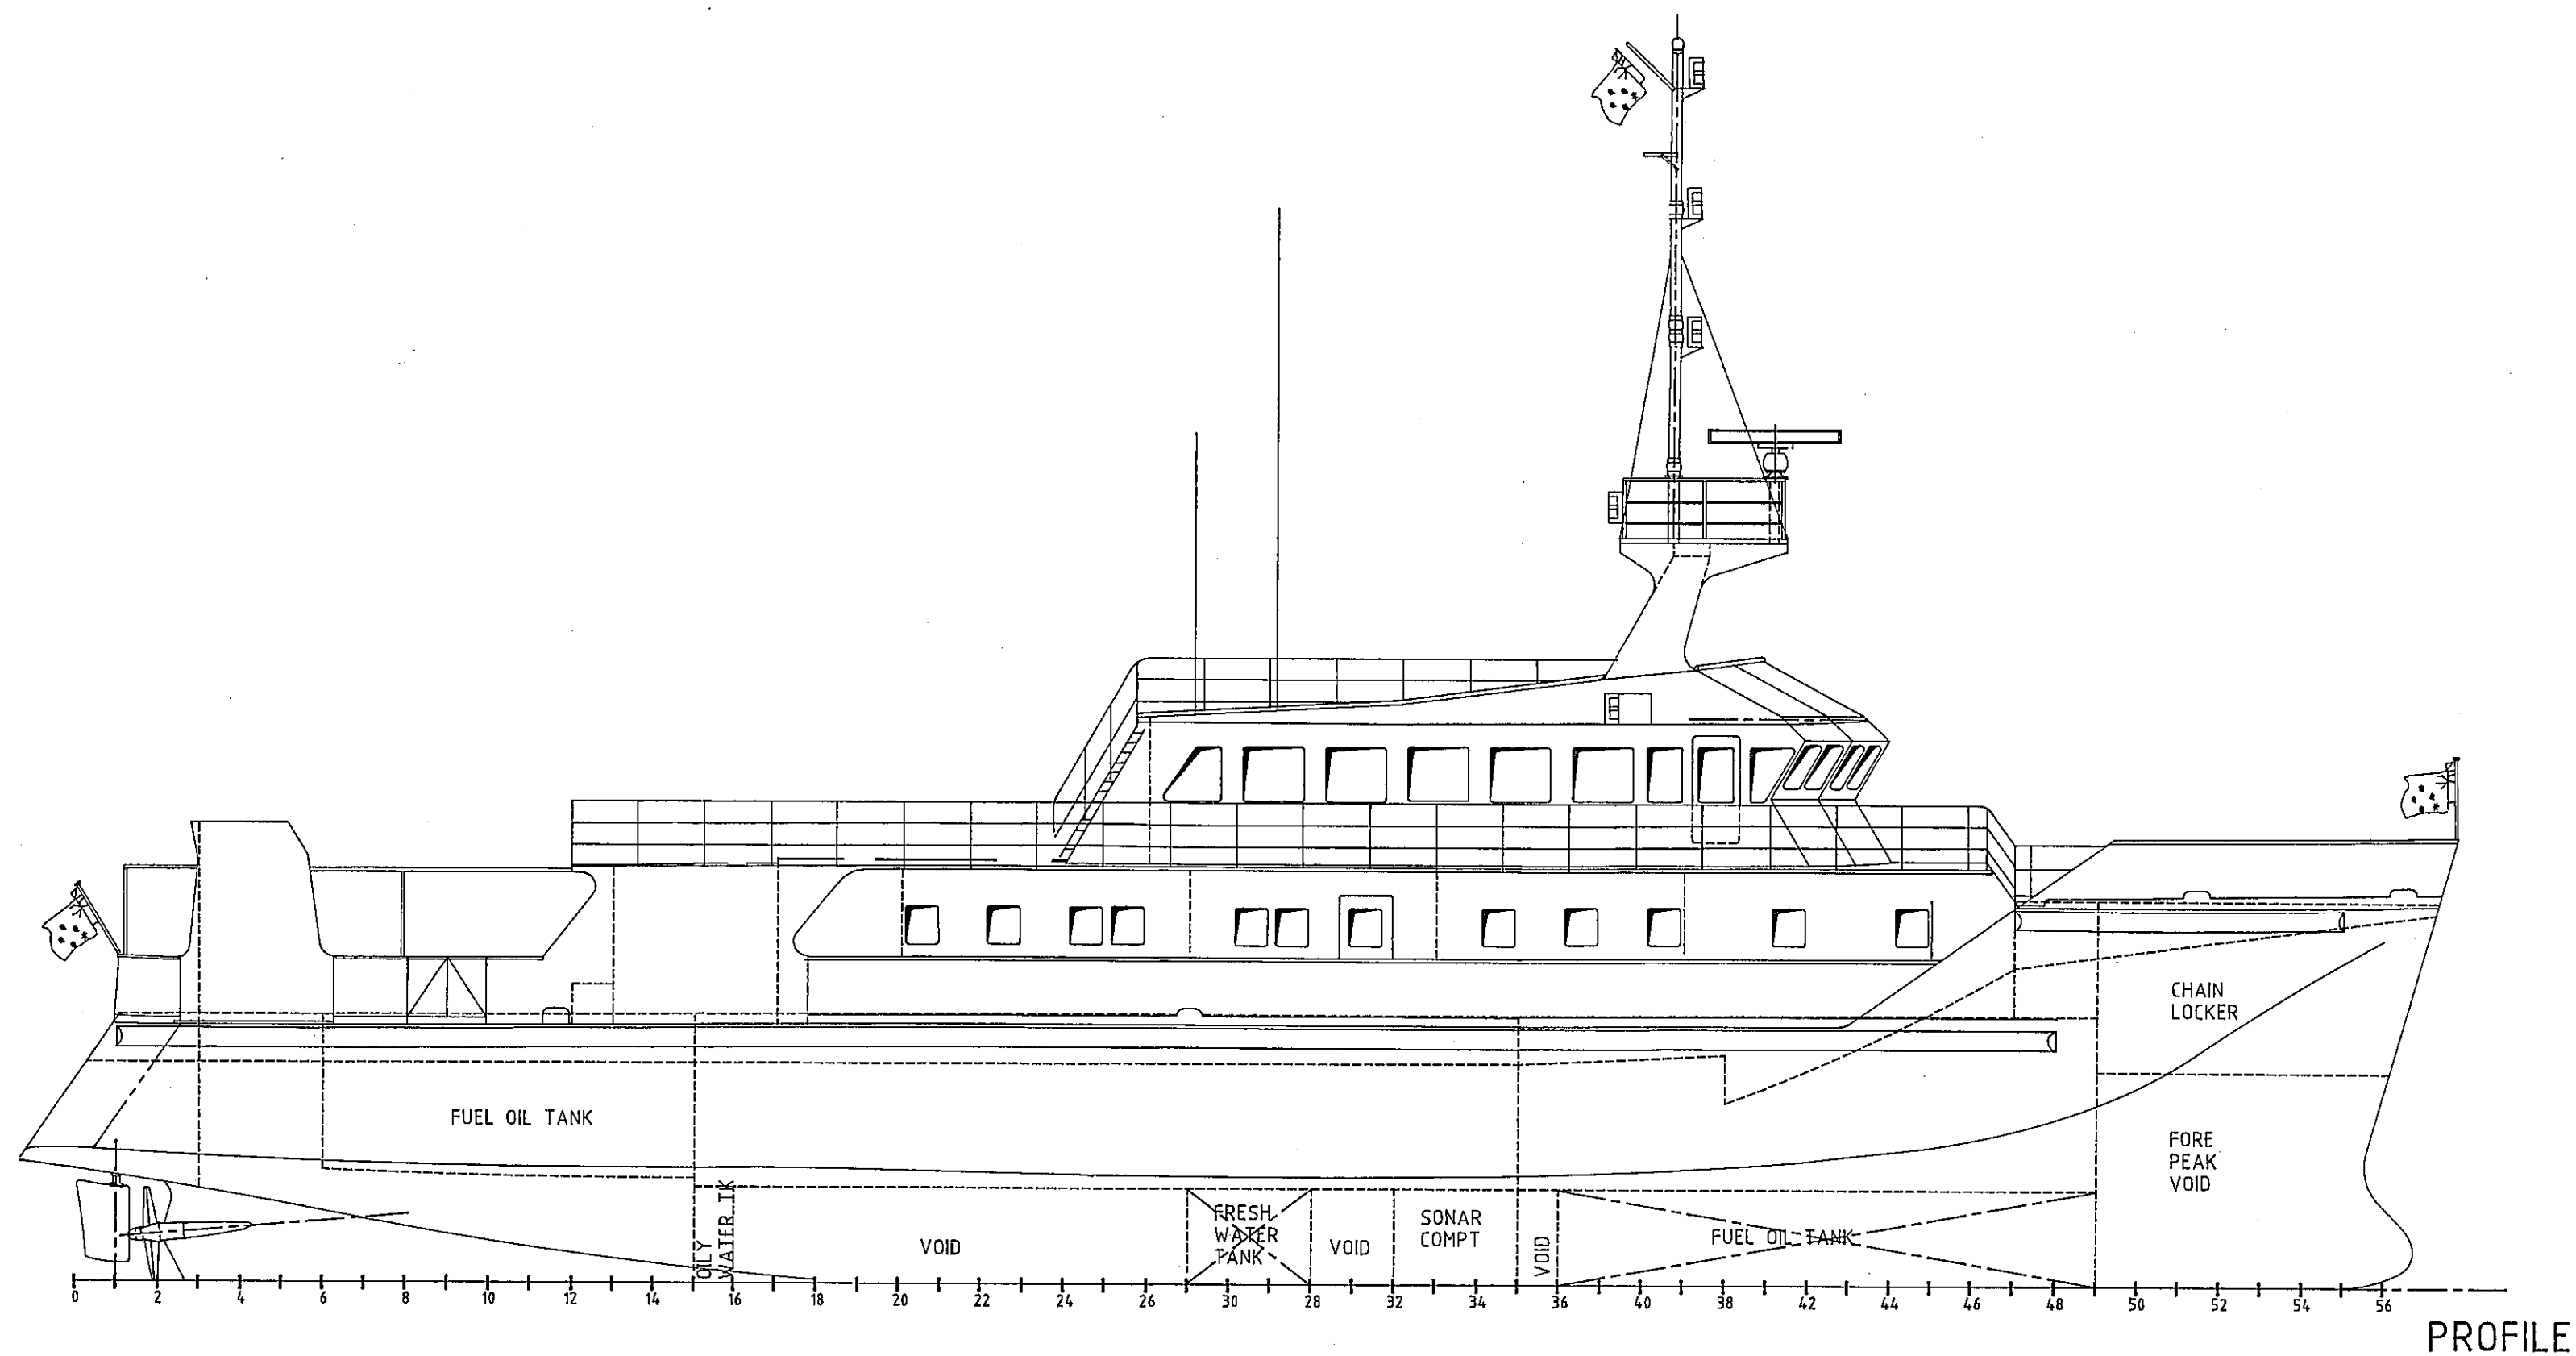

PROFILE

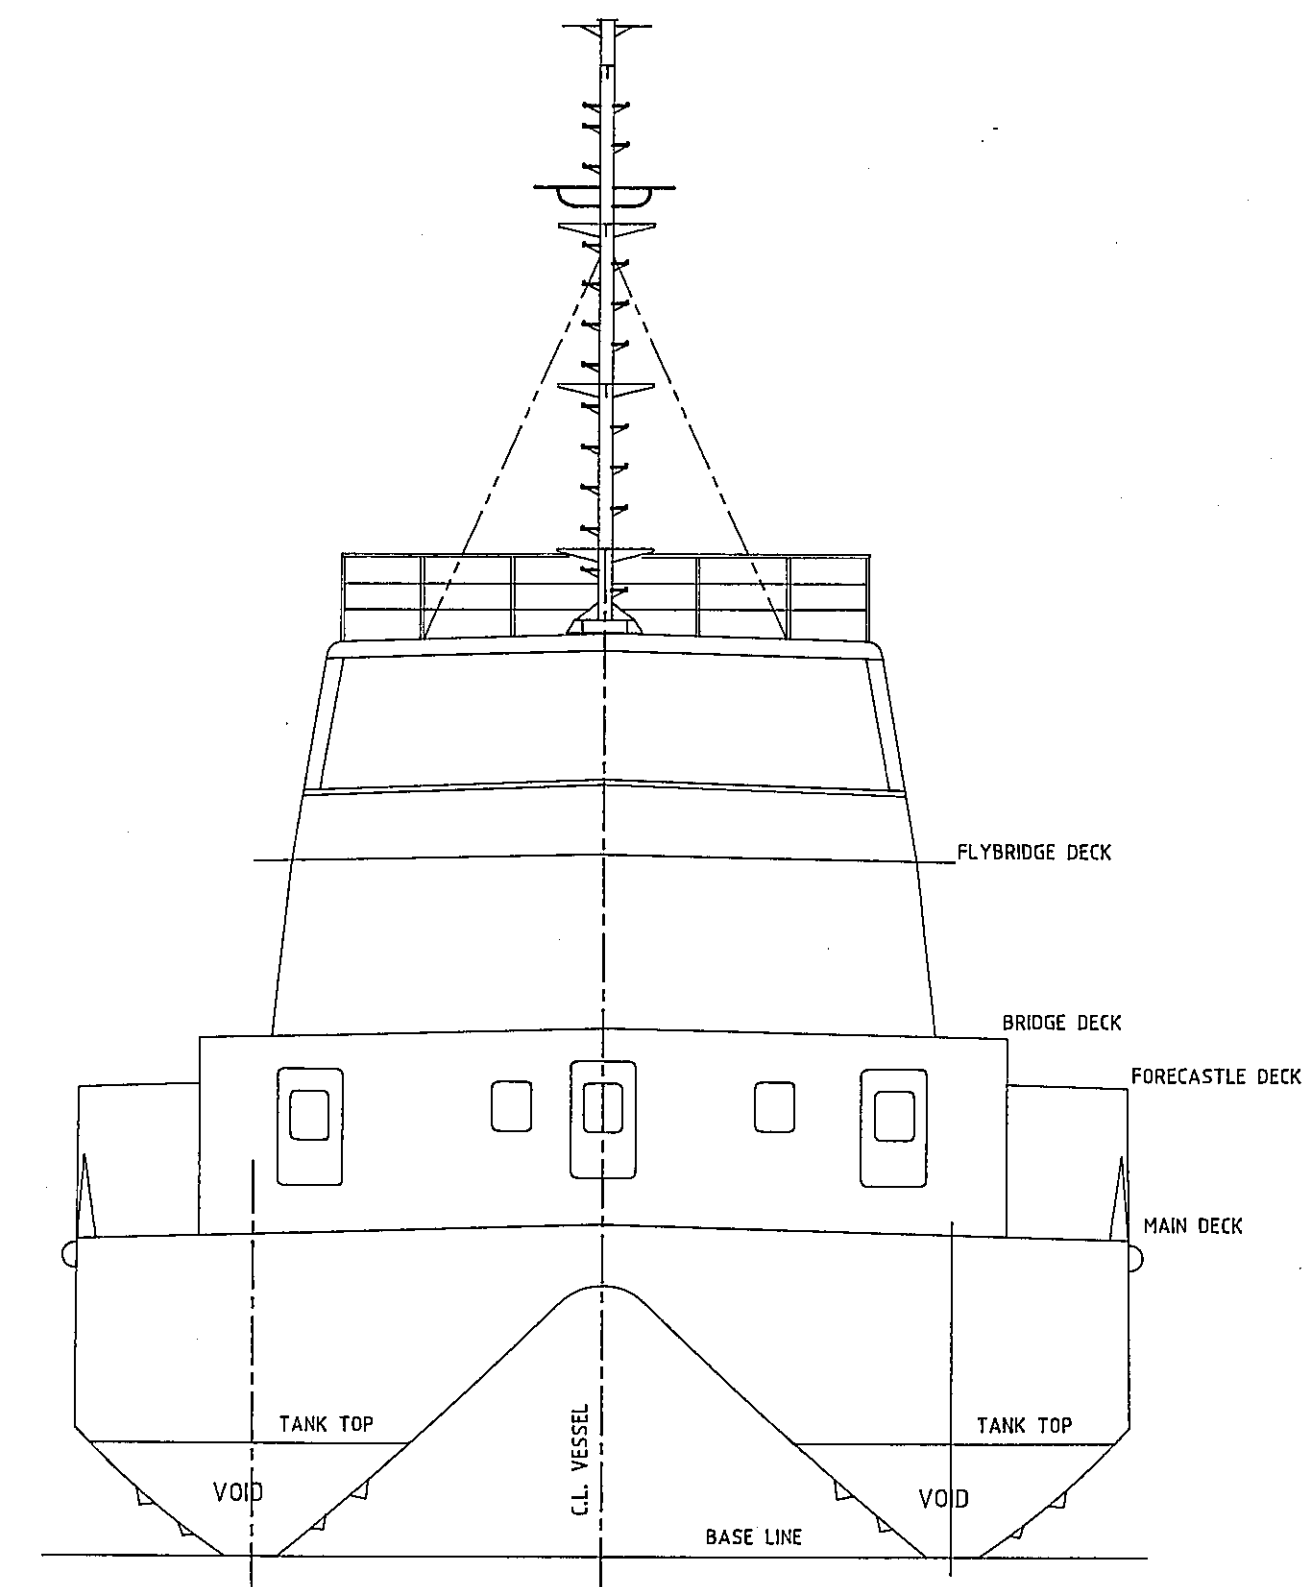

SECTION FR. 18 LOOKING FWD.

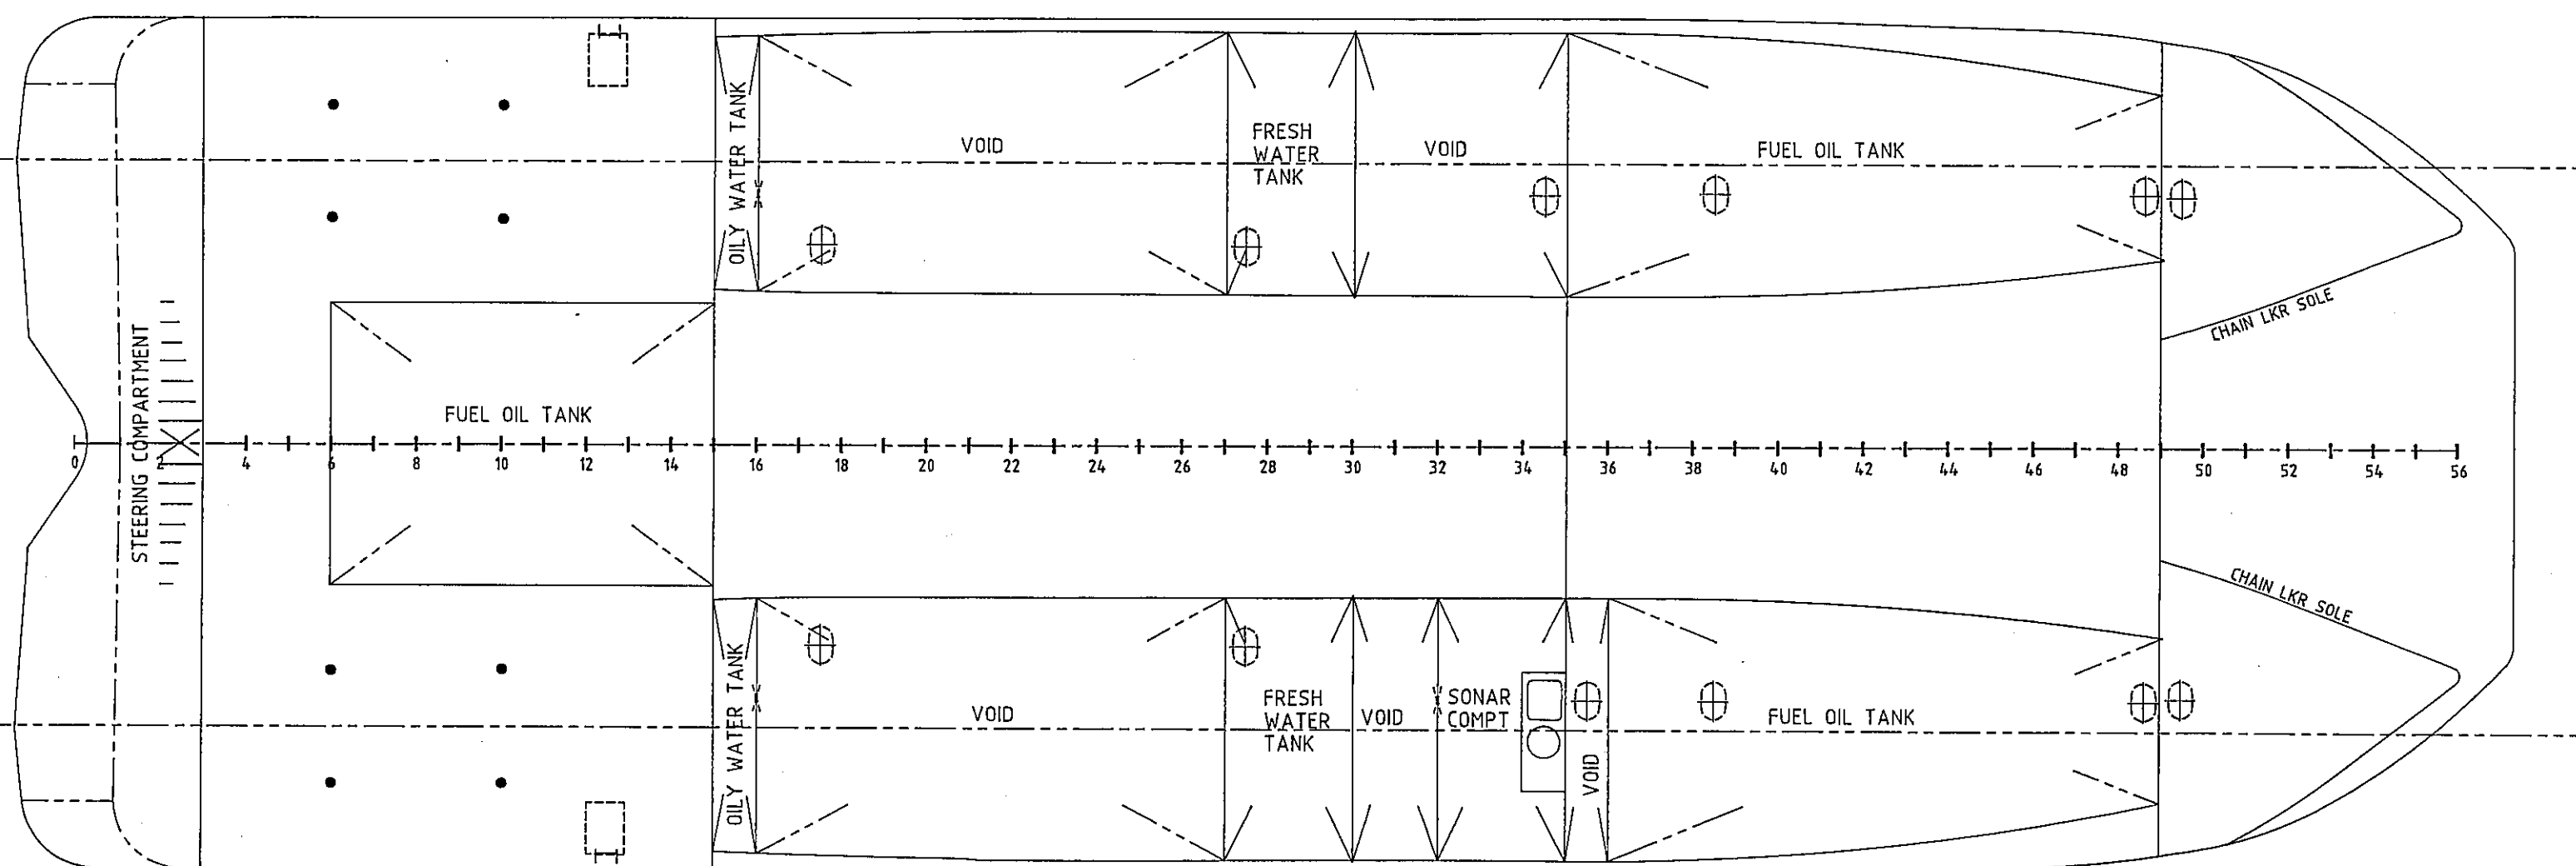

BELOW TANK TOP

TANK	POSITION	DENSITY KG/CU.M	CAPACITY LITRES	V.C.G. MM A.BASE	L.C.G. MM FROM
AFT FUEL TANK	FRS.6 -15	84.0	33000	3297	10489A
OILY WATER TANK (P)	FRS.15-16	1000	1820	925	7385A
OILY WATER TANK (S)	FRS.15-16	1000	1820	925	7385A
FRESH WATER TANK (P)	FRS.27-30	1000	6100	894	670F
FRESH WATER TANK (S)	FRS.27-30	1000	6100	894	670F
FWD FUEL TANK (P)	FRS.36-49	84.0	25300	884	8775F
FWD FUEL TANK (S)	FRS.36-49	84.0	25300	884	9101F
LUBE OIL TANK (P)	FRS.7 -8	800	400	2780	12310A
LUBE OIL TANK (S)	FRS.7 -8	800	400	2780	12310A
HYDRAULIC OIL TANK (S)	FRS.3- 4	800	290	2904	2191

DISTRIBUTION LIST		REV. NO.		DATE		REVISION		BY		APP.		PRINT	
R.A.M.		4/1		90		BENALLA - "AS BUILT"		K.B.		D.J.			
L.R.S.													
PROD. PT.													
C.C.													
N/HELL													
PROC.													
CAD													
THE INFORMATION DISCLOSED IN THIS DOCUMENT IS CONFIDENTIAL AND IS NOT TO BE RELEASED OR DISCLOSED IN ANY FORM OR BY ANY MEANS, WITHOUT THE EXPRESS WRITTEN CONSENT OF ELGO ENGINEERING PTY. LTD. TO BE USED, REPRODUCED OR IN ANY FORM OR BY ANY MEANS, WITHOUT THE EXPRESS WRITTEN CONSENT OF ELGO ENGINEERING PTY. LTD. ELGO ENGINEERING PTY. LTD. ADELAIDE, SOUTH AUSTRALIA.													
DRAWING TITLE													
HMAS BENALLA - "AS BUILT"													
CAPACITY PLAN.													
TOTAL													
REV.		DRAWN		D.JILLY		28/1/89		ELGO ENGINEERING DRAWING NUMBER		REVISION			
CHECKED		M.H.		28/1/89									
DATE		APPROVED		J.P.		28/1/89							
SCALE		1:500											

7/2-019 R-AB